


 
ISS	DESCRIPTION	DATE	APPR
B	ADD C8, R17	29 APR 74	M. DRAKE
C	R2 WAS 10K - R10 WAS 91K - Q2 WAS 2N3645 R16 DELETED	8 AUG 74	M. DRAKE
D	R16 REHABILITATED	5 SEP 74	M. DRAKE
E	R16 BANISHED R1 WAS 20K R11 WAS 101K	22 JAN 75	M. DRAKE
F	Q2 WAS 2N 404 R3 WAS 1K R6 WAS 33K R7 WAS 2K R10 WAS 39K	5 JAN 77	J. WOOD

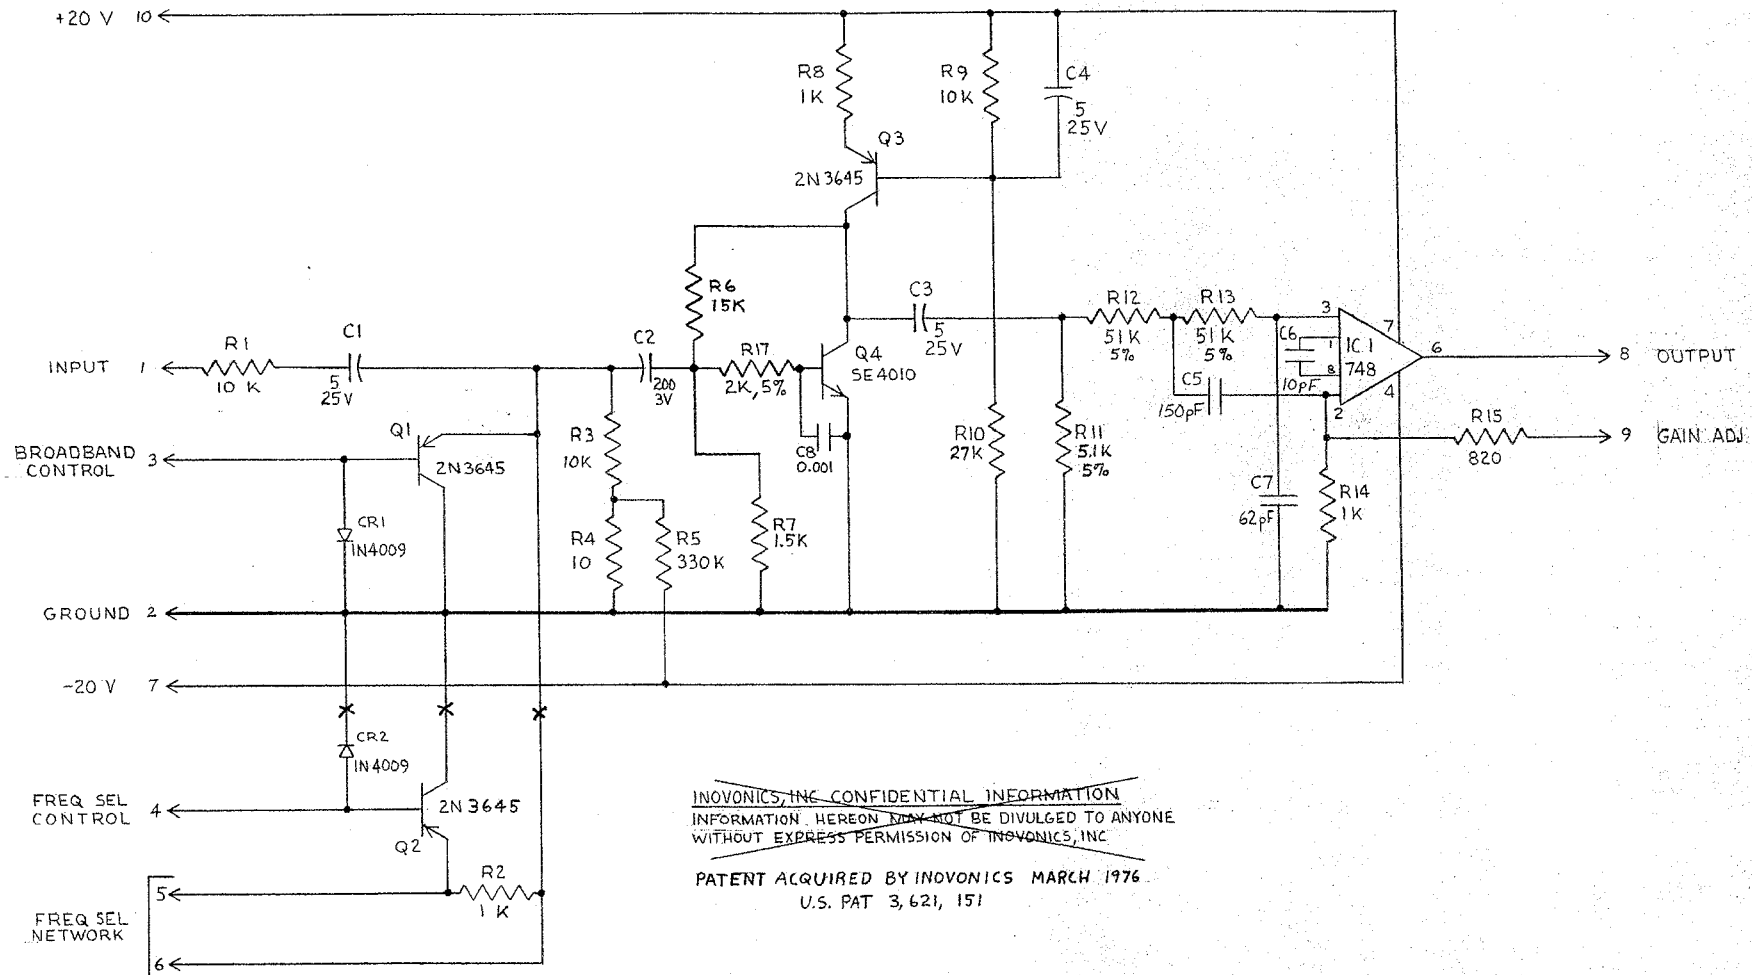

~~INOVONICS, INC. CONFIDENTIAL INFORMATION~~
~~INFORMATION HEREON MAY NOT BE DIVULGED TO ANYONE~~
~~WITHOUT EXPRESS PERMISSION OF INOVONICS, INC.~~

PATENT ACQUIRED BY INOVONICS MARCH 1976
U.S. PAT 3,621, 151

LAST USED	
REF	DESIG
C	8
CR	2
IC	1
Q	4
R	17

201 210 220	DRAWN	M.D.	2 FEB 73		1630 Dell Avenue, Campbell, Calif. 95008 Phone 374-3300
	CHECKED				
	APPROVED	<i>JBW</i>	5 FEB 73		
TOLERANCES		TITLE			
MATERIAL		SCHEMATIC - GAIN CONTROL MODULE			
2PL ± .01 3PL ± .005 ANGLES ± 1°	FINISH	PAGE 1 / 1		DWG NO 110400	ISSUE F